PARTITION KEY

REFER TO GENERAL NOTES ON A002 FOR ADDITIONAL INFORMATION
SEE A920 FOR PARTITION SCHEDULE & STANDARD PARTITION DETAILS

WALL — XX.X / XXX

PARTITION TYPE:
REFERENCE DETAILED TYPE INFORMATION & SCHEDULE ON A920

PARTITION TAG

PARTITION HEIGHT:
BLANK - INDICATES NON-RATED PARTITIONS STOP ABOVE CEILING & RATED PARTITIONS EXTEND TO DECK. SEE TYPICAL DETAILS BELOW

DECK - INDICATES PARTITION EXTENDS TO UNDERSIDE OF STRUCTURAL DECK. TYPICAL FOR ALL RATED PARTITIONS. SEE TYPICAL DETAIL BELOW

X'-.X" - INDICATES SPECIFIC HEIGHT OF PARTITION ABOVE TOP OF SLAB

PARTITION PLAN SYMBOLS

- 1 HOUR PARTITION
- 2 HOUR PARTITION
- 3 HOUR PARTITION
- METAL STUD PARTITION
- MASONRY PARTITION

PARTITION PLAN NOTES

1. DIMENSIONS AT INTERIOR METAL STUD WALLS ARE TO THE FACE OF GYP., U.N.O.
2. DIMENSIONS AT EXTERIOR TILT WALLS ARE TO THE INSIDE FACE OF CONCRETE, U.N.O.
3. DIMENSIONS AT DOORS ARE TO THE OUTSIDE EDGE OF DOOR FRAME. ALL DOOR DIMENSIONS TO BE 4" FROM FACE OF GYP., U.N.O.
4. REFER TO SHEET A19.1 FOR WALL TYPES.
5. COORDINATE MECH, PLUMBING, AND ELEC PENETRATIONS WITH THEIR RELATED DISCIPLINES. INSTALLER TO VERIFY ALL LOCATIONS AT CONCRETE SLAB.
6. INSTALL SOUND ATTENUATION BATT INSULATION AT INTERIOR PARTITIONS NOT PART OF THERMAL ENVELOPE. INSTALL INSULATING BATT INSULATION AT OFFICE/WAREHOUSE DEMISING PARTITIONS AND ALL PARTITIONS AGAINST EXISTING TILT WALLS

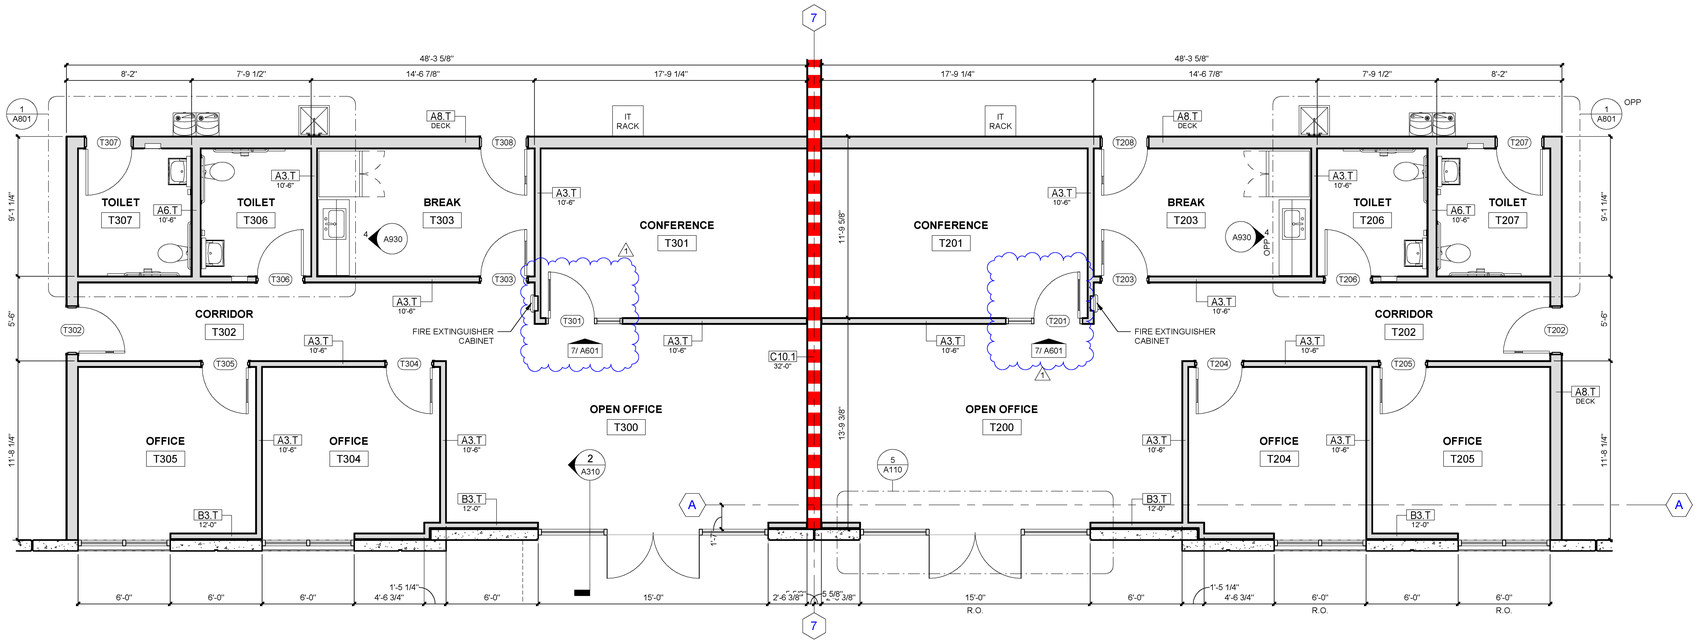

3 A111 OFFICE PARTITION PLAN - CENTER
SCALE: 1/4" = 1'-0"

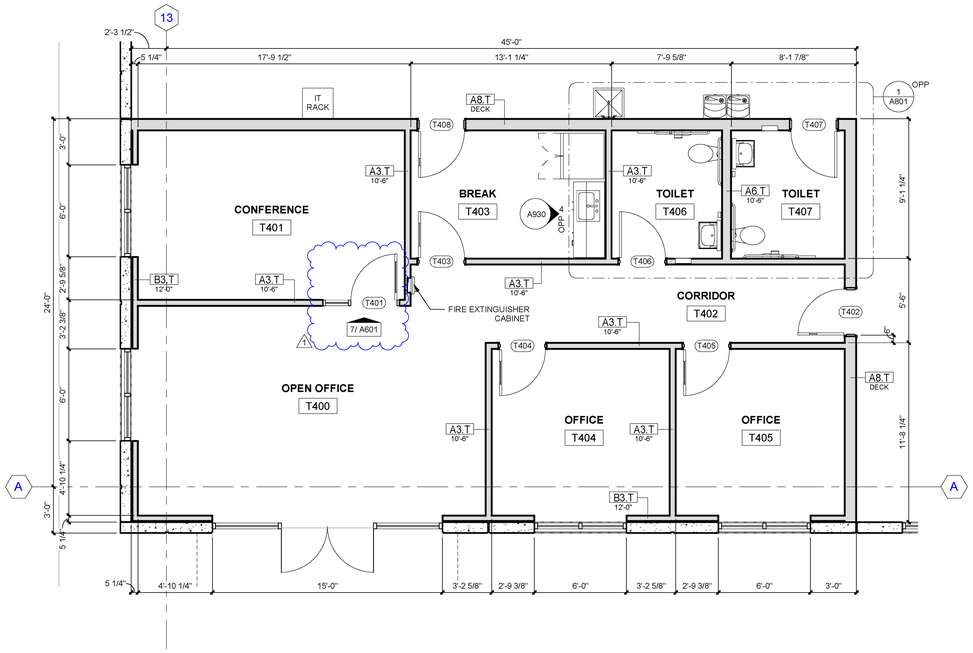

2 A111 OFFICE PARTITION PLAN - CORNER WEST
SCALE: 1/4" = 1'-0"

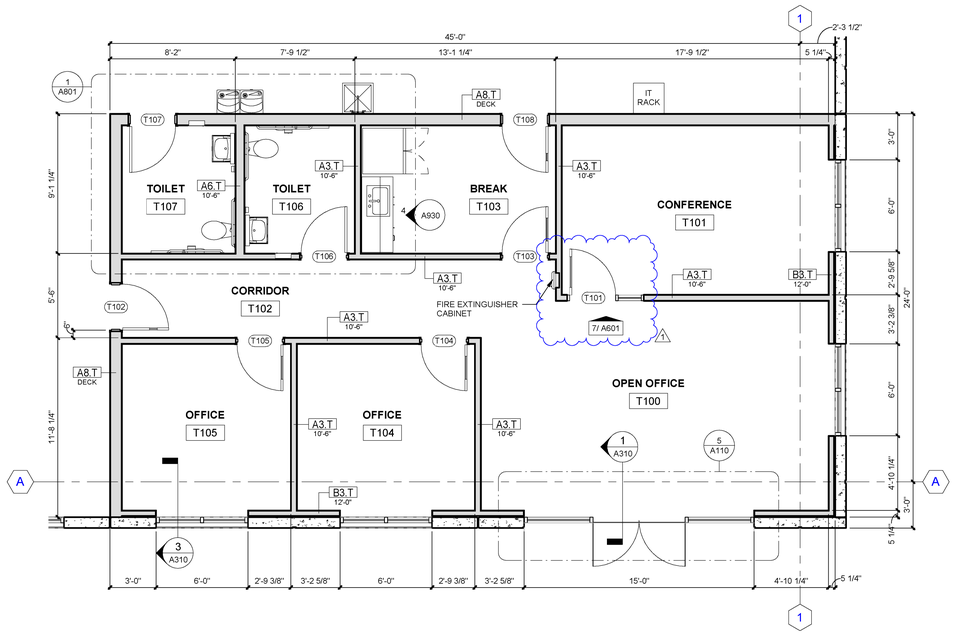

1 A111 OFFICE PARTITION PLAN - CORNER EAST
SCALE: 1/4" = 1'-0"

COPYRIGHT © 2024: ONEFOURTWO ARCHITECTURE PC

DESIGN BUILDER:
ARCO DESIGN/BUILD

DESIGNER/ ENGINEER:
ONE FOUR TWO ARCHITECTURE

OWNER:
Hazel Street

PROJECT TITLE:
PARK 295 LANDING

2555 IGNITION DRIVE
JACKSONVILLE, FL
32218

SEAL:
STATE OF FLORIDA
MATTHEW ROBERTS
AR99018
REGISTERED ARCHITECT
01/10/2025

SUBMITTALS / REVISIONS:

NO.	DATE	DESCRIPTION
	2024.10.15	ISSUED FOR PERMIT
1	2025.01.10	REVIEW COMMENTS

PROJECT NO.: DS355-24
DRAWN BY: JES

SHEET TITLE:
OFFICE PARTITION PLANS

These drawings are the property of the registered Designer/ Engineer and may not be copied, reproduced or used without their written permission.

SHEET NUMBER:
A111